



- NOTES:
- THIS DRAWING WAS COMPILED FROM INFORMATION PROVIDED BY WANZEK, UTILIZING INFORMATION FROM THE FOLLOWING FILE LIST.
    - a. CRM\_AvoidanceBuffer\_110813.SHX
    - b. USFWS\_WetEase\_1012.SHX
    - c. Wetlands\_Poly\_102314.SHX
    - d. Courtenay\_TurbineArrayRenumbering\_2015\_07\_15.SHX
    - e. Courtenay ALTA 150120.DWG
    - f. Courtenay\_CollectionRecordLines\_20161108.SHP
    - g. Courtenay\_AdditionalSurveyCorridor\_2015\_10\_07.kmz
  - THE AERIAL WAS OBTAINED BY ULTEIG.
    - g. CourtenayAerial\_NDStateplane\_HarrNAD83\_South\_IntlFt.SID

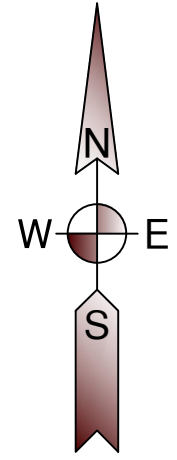

**RECORD DRAWING**  
DRAWINGS ARE BASED UPON  
CONSTRUCTION CONTRACTOR REDLINES  
WHICH HAVE NOT BEEN FIELD VERIFIED BY  
ENGINEER OF RECORD.

LEGEND	
	WIND TURBINE
	FEEDER 1
	FEEDER 2
	FEEDER 3
	FEEDER 4
	FEEDER 5
	FEEDER 6
	FEEDER 7
	FEEDER 8
	FIBER ROUTE
	SURVEYED CORRIDORS
	RIGHT OF WAY
	NON LEASED
	JUNCTION BOX
	CABLE SPLICE
	FIBER SPLICE
	MID SPAN GROUND
	ACCESS ROADS
	BORE LOCATION

REVISION							ZONE	DATE	BY	CHK	ENG	NO	REVISION							ZONE	DATE	BY	CHK	ENG	REFERENCE DRAWINGS			<div><div>NORTHERN STATES POWER COURTENAY WIND - COLLECTION SYSTEM STUTSMAN COUNTY, NORTH DAKOTA</div></div>	THIS MAP/DOCUMENT IS A TOOL TO ASSIST EMPLOYEES IN THE PERFORMANCE OF THEIR JOBS. YOUR PERSONAL SAFETY IS PROVIDED FOR BY USING SAFETY PRACTICES, PROCEDURES, AND EQUIPMENT AS DESCRIBED IN THE SAFETY TRAINING PROGRAMS AND MANUALS.		UNIT 0				
A	90% SUBMITTAL							10/12/2015	MJ	JH	BG														DWG NO.	MANUFACTURER	DESCRIPTION			FEEDER ROUTING DIAGRAM SECTION 18, T143N, R62W					
0	ISSUED FOR CONSTRUCTION							01/22/2016	AS	JH <td>BG</td> <td></td> <td></td> <td></td> <td></td> <td></td> <td></td> <td></td> <td></td> <td></td> <td></td> <td></td> <td></td> <td></td> <td></td> <td></td> <td></td> <td></td> <td></td>	BG																								
1	REVISED KEY MAP							02/10/2016	CL	JH <td>BG</td> <td></td> <td></td> <td></td> <td></td> <td></td> <td></td> <td></td> <td></td> <td></td> <td></td> <td></td> <td></td> <td></td> <td></td> <td></td> <td></td> <td></td> <td></td>	BG																								
2	RECORD DRAWING							12/05/2016	GP	JH <td>BG</td> <td></td> <td></td> <td></td> <td></td> <td></td> <td></td> <td></td> <td></td> <td></td> <td></td> <td></td> <td></td> <td></td> <td></td> <td></td> <td></td> <td></td> <td></td>	BG																								
																											DWN: MJ	DATE:01/22/2016	CHK:	DATE:	ENERGY SUPPLY ENGINEERING & CONSTRUCTION		NH-271536-28		REV 2
																											ENG: BG	DATE:01/22/2016	CHK:	DATE:					
																											PM: BD	DATE:01/22/2016	PROJ. NO: 121901101						
																											APVD:	DATE:	SCALE:NONE						